



FIRST FLOOR PLAN  
1/8" = 1'-0"

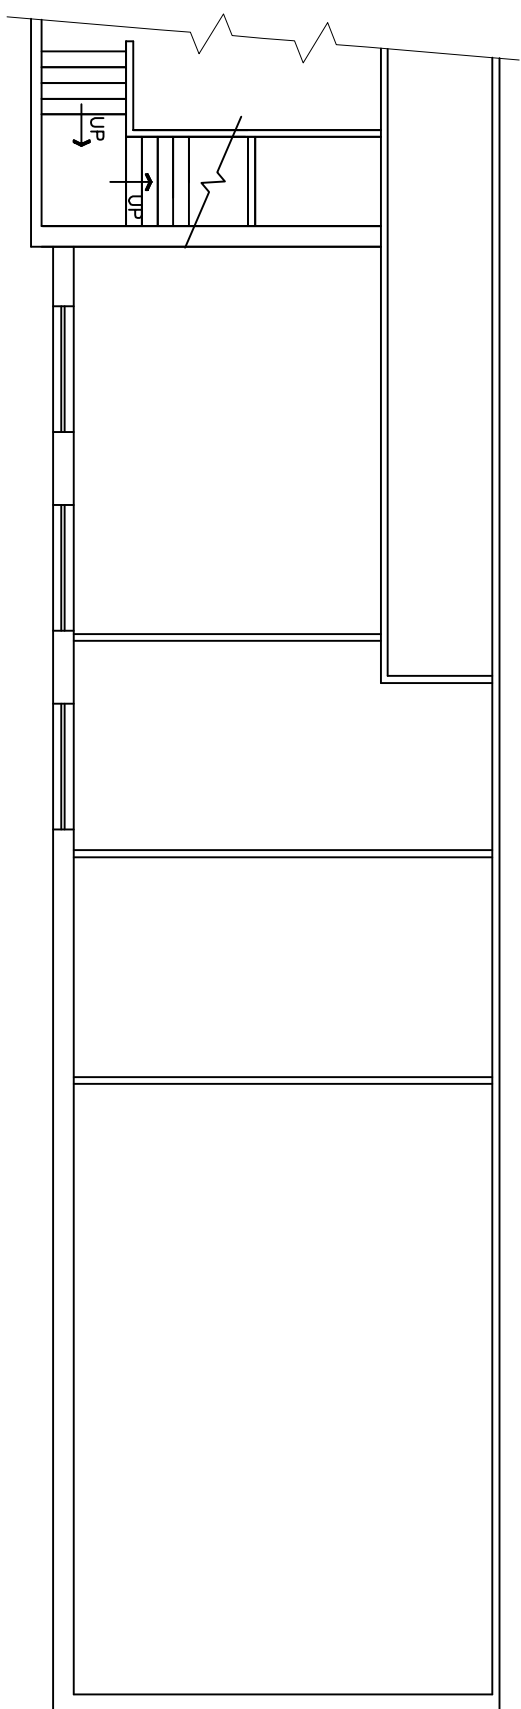

FIRST FLOOR PLAN  
1/8" = 1'-0"

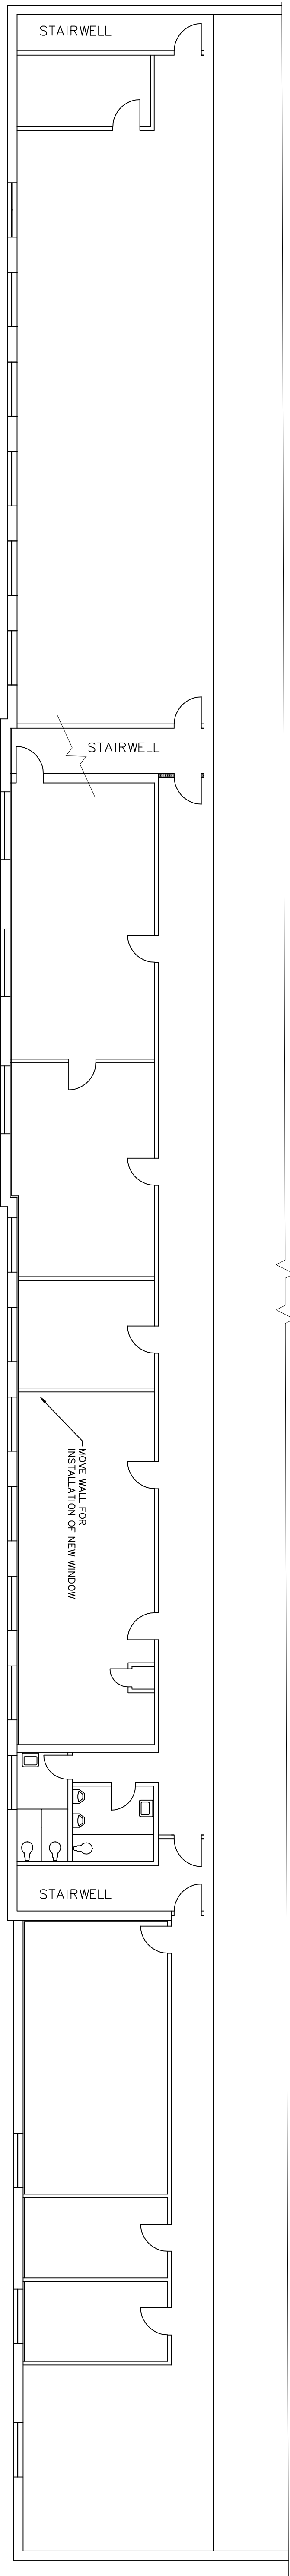

SECOND FLOOR PLAN  
1/8" = 1'-0"

JUL 05		ASBUILT		D.L.W.	
16 SEP 03		35% DESIGN DRAWING			
REV	DATE	DESCRIPTION	BY	CHKD	APPD
CHUGACH MANAGEMENT SERVICES, INC.					
5007 WIL L 6225					
ANCHORAGE, AK 99502-4135					
(607) 744-5613					
607) 565-0606					
BASE OPS WINDOWS					
BUILDING 433, HANGAR I					
FLOOR PLANS					
STANDARD		APPROVED		APPROVED	
DRAWN BY		DESIGNED BY		CHECKED BY	
DATE		DATE		DATE	
SCALE		PROJECT NO.		DRAWING NO.	
1/8" = 1'-0"		D005253		W00020400	
				PAGE NO.	
				3 OF 3	